




GROUND FLOOR OFFICES
Scale 1:200

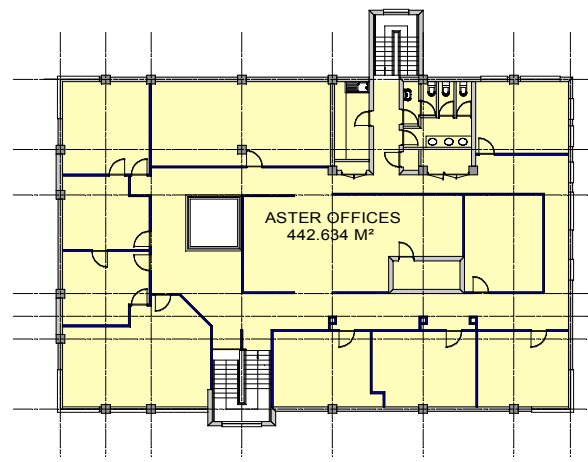


FIRST FLOOR OFFICES
Scale 1:200

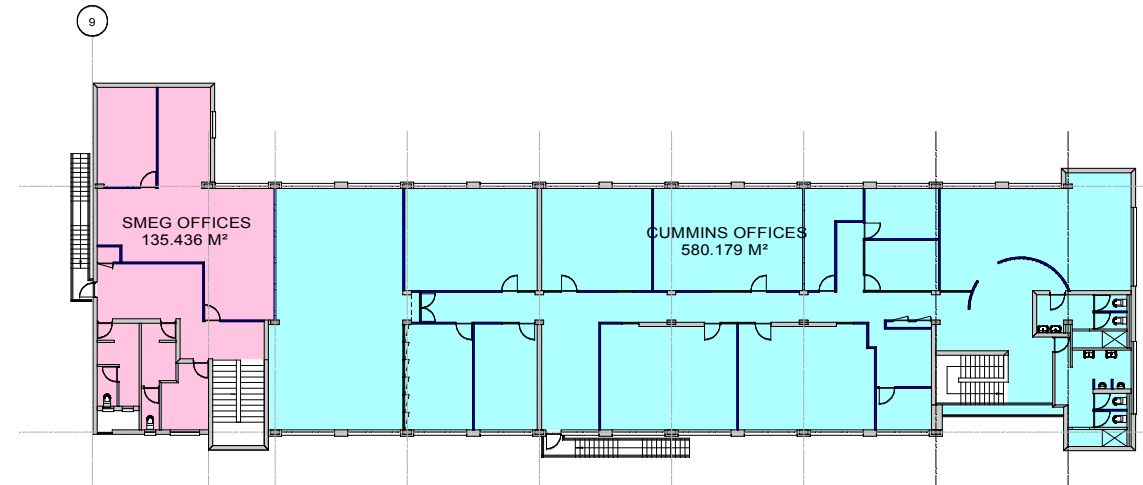

FIRST FLOOR OFFICES
Scale 1:200

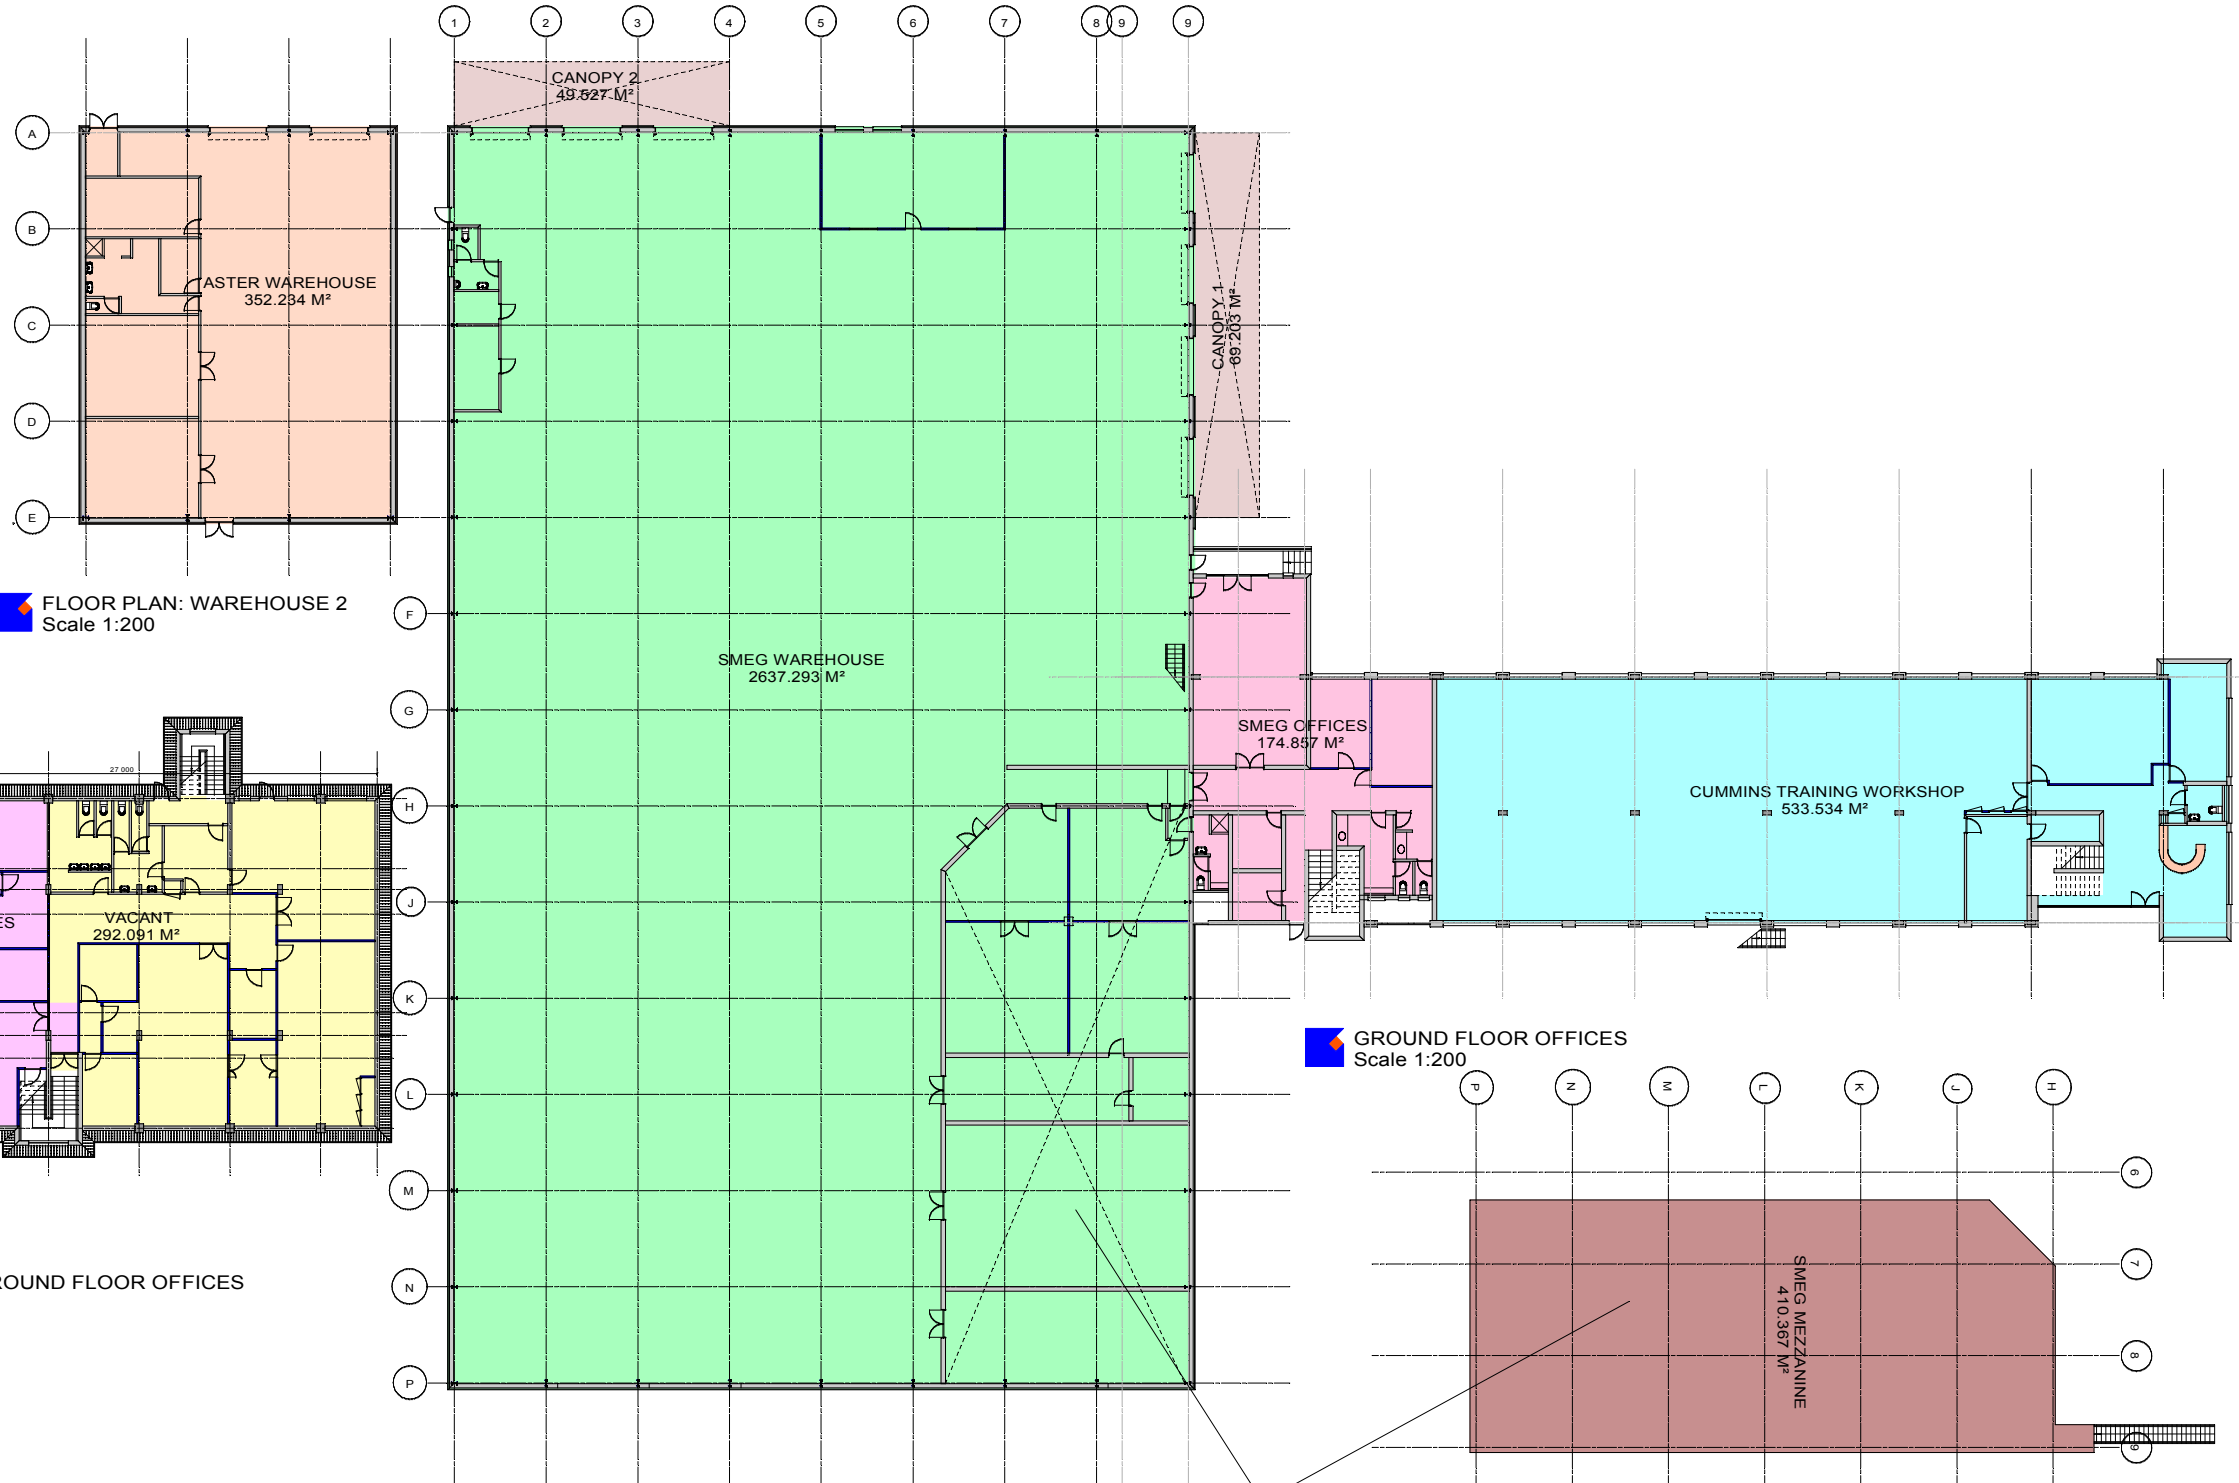


FLOOR PLAN: WAREHOUSE 2
Scale 1:200

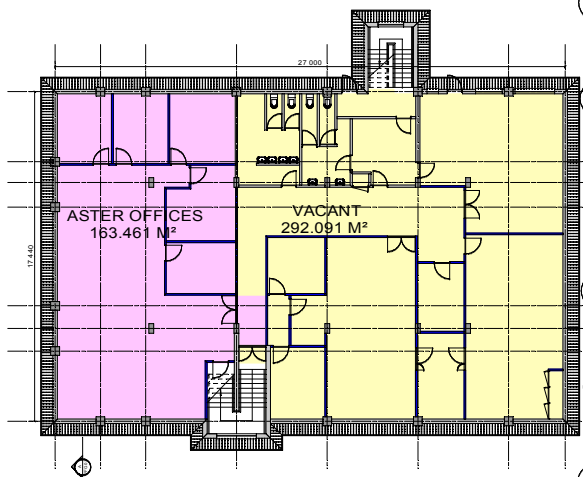

LOWER GROUND FLOOR OFFICES
Scale 1:200

FLOOR PLAN: WAREHOUSE 1
Scale 1:200

GROUND FLOOR OFFICES
Scale 1:200

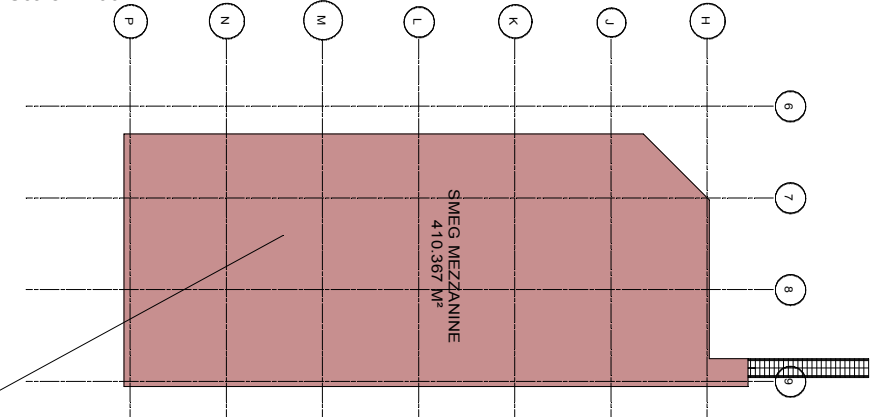

MEZZANINE FLOOR PLAN:
Scale 1:200

NOTES
ALL DIMENSIONS AND LEVELS ARE TO BE VERIFIED ON SITE PRIOR TO COMMENCING SETTING OUT WORKSHOP DRAWINGS OR CONSTRUCTION.
FIGURED DIMENSIONS ONLY TO BE USED.
DISCREPANCIES, ERRORS AND OMISSIONS ARE TO BE REPORTED TO THE ARCHITECTS IMMEDIATELY SHOULD THEY BECOME EVIDENT.
ALL BALUSTRADES ARE A DESIGN AND SUPPLY CONTRACT, AND THE SUBCONTRACTOR MUST PROVIDE A PROFESSIONAL ENGINEERS CERTIFICATE ON COMPLETION. ALL SHOP DRAWINGS SUBMITTED FOR APPROVAL, NEED TO BE FIRST SIGNED OFF BY THE SUBCONTRACTOR'S PROFESSIONAL ENGINEERS PRIOR TO SUBMITTAL.
SHOP DRAWINGS TO BE SUBMITTED FOR APPROVAL PRIOR TO MANUFACTURE OR INSTALLATION.
COPYRIGHT AND RIGHT OF REPRODUCTION OF THIS DRAWING OR ANY PORTION THEREOF IS RESERVED BY LEON KRÜGER ARCHITECTS.

REVISIONS			
DATE	REVISION	DESCRIPTION	BY
14-03-2013	A	CANOPY AREA'S ADDED	ATD
14-03-2013	B	MEZZANINE FLOOR ADDED	ATD

This building was measured by LKA using a HILTI PD 42 Laser Range Meter, and the dimensions are as we found them at the date of this drawing.
All buildings are measured according to the SAPOA guide method of measuring floor areas.

Leon Krüger Architects
First Floor, Block Park
189 Panorama Road
Rondebosch
Cape Town
Private Bag X1
The Kloof
6981
Tel: 012 661 3886
Cell: 082 577 2809
Fax: 086 915 4733
leon@wvka.co.za

LEON KRÜGER ARCHITECTS
FUNCTIONAL • ELEGANT

PROJECT NAME
AS BUILT DRAWINGS OF IMPALA ROAD ON RE / 89 EASTGATE EXT. 8 FOR GROWTHPOINT PROPERTIES.

ISSUED FOR	PRELIMINARY	INFORMATION	TENDER CONTRACT	MEASUREMENT	CONSTRUCTION	APPROVAL	OPERATIONAL
UITGEREIK VIR	VOORLOOPS	PLANNING	TENDER KONTRAKT	MEETWATERS	KONSTRUKSIE	GOEDKEURING	DRYFT

SCALE/SKAAL	1:200	DRAWN/GETEKEN	ATD
DATE/DATUM	2013-03-14	CHECKED/NADESIEN	ATD
STAGE/FASE		WORKING DRAWING	

DRAWING TITLE
IMPALA ROAD

AS BUILT
GROUND FLOOR PLAN

DRAWING NO	J14 590 PFG01	REVISION NO	B
PLOT DATE 17/03/2016 TIME 13:58:56			